

Addendum No. 2

TO: PROPOSED BIDDERS

PROJECT: ERBR-30(02) PARKERS LAKE BRIDGE, JACKSON COUNTY

DATE: NOVEMBER. 20, 2020

- 1. Contract time is being revised to a **320 WORKING** day contract. All references to contract time requirements shall be changed accordingly.
- 2. The bid date is being extended to **December 1, 2020**, to allow additional time for review of the following information being posted for the project. (time requirements for submittal of bids to remain unchanged).
- 3. Revise the bridge removal note on Sheet 4, as follows:

"Station 20+88.53 - Existing 440 L.F. CAST-IN-PLACE bridge to be removed under pay item S-202-B and will become PROPERTY OF THE CONTRACTOR." (Contractors may contact MDWFP for their expressed interest in any salvageable materials which the agency could use).

In this respect, a copy of the original bridge plans are being made available under the engineer's website at <u>www.batsonandbrown.com</u> for contractors review and use in planning removal work requirements.(Note wherein the original pile depths as installed under SAP-30(1) were reduced due to scour and a maintenance project SAP-30(5)M installed the pipe piles to reinforce the existing substructure.)

Removal of existing piles to be made at the existing mulline for all areas in the channel and a minimum of 3' below the mulline all other areas.

- 4. Cross-Section sheets for dirt quantities are being made available for review under the website at <u>www.batsonandbrown.com</u> for contractor's review.
- 5. Stay in Place forms are allowed for construction of the bridge deck, reference note on Sheet I.
- 6. Pay Item for Exploration, shall be in accordance with Section S.803.03.2.3.7- Excavation, of the Standard Specification for State Aid Roads Road and Bridge Construction, 2004 edition. This item of work is being established to address any field conditions which may

represent a substantial change from the referenced geotechnical soils report during work to install the permanent drill shafts. Payment to be made in accordance with referenced specification section.

Please place this Addendum on the inside cover of your Contract Documents. Bids will not be accepted without this Addenda being attached to your documents

Sign and date below, and return a copy of this sheet to our office immediately by email to kimberly@batsonandbrown.com.

Sob Jamon Bob Diamond, P.E.


Acknowledgement of receiving Addendum No. 2, ERBR-30(02) PARKERS LAKE BRIDGE **REPLACEMENT PROJECT**, is made by:

Received by: _____

_____ Company:

Signed: _____

Date:

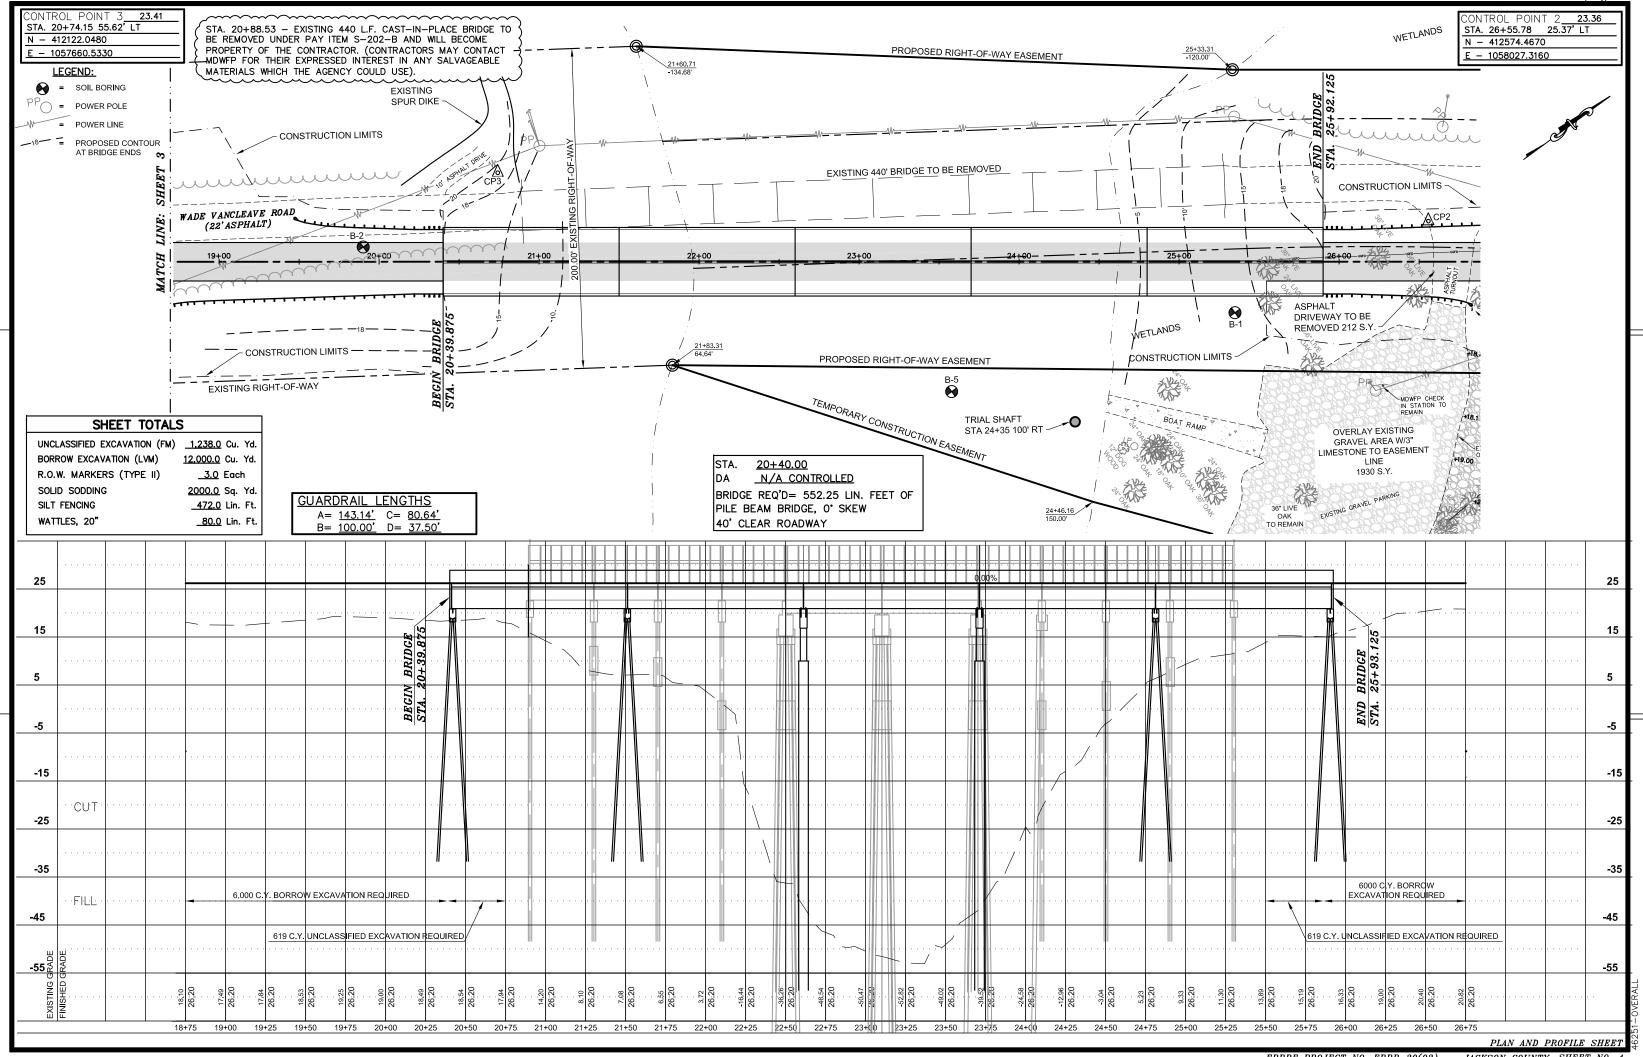

ERBRF PROJECT NO. ERBR-30(02),

ERBRF PROJECT NO. ERBR-30(02), JACKSON COUNTY SHEET NO. 4